

AMENDMENTS

PROCLAMATION  
LEGEND

EXISTING PROCLAIMED ROUTE

- H6** Highway  
(^ Road Name)
- M42** Main Road  
(^ Road Name)
- P18** Main Roads Controlled Path \*

SECTION TO BE DE-PROCLAIMED

- ~~H2~~
- ~~M12~~
- ~~P18~~

SECTION TO BE PROCLAIMED

- H6** Highway
- M42** Main Road
- P18** Main Roads Controlled Path \*

\* Main Roads Western Australia controlled paths referred to as "footpaths" in Section 13(1) of the Main Roads Act 1930, as amended.

Paths depicted on this drawing are those for which Main Roads Western Australia has responsibility. Paths the responsibility of other entities are not shown.

^ Landgate approved local usage name.

This is to certify that Council endorses the proposal shown on this plan.

Council Resolution:.....of

Council Meeting Held On:.....


Chief Executive Officer

Date:.....

Gazette:.....

Page No:.....

THIS DRAWING SUPERSEDES: 0921-378-00

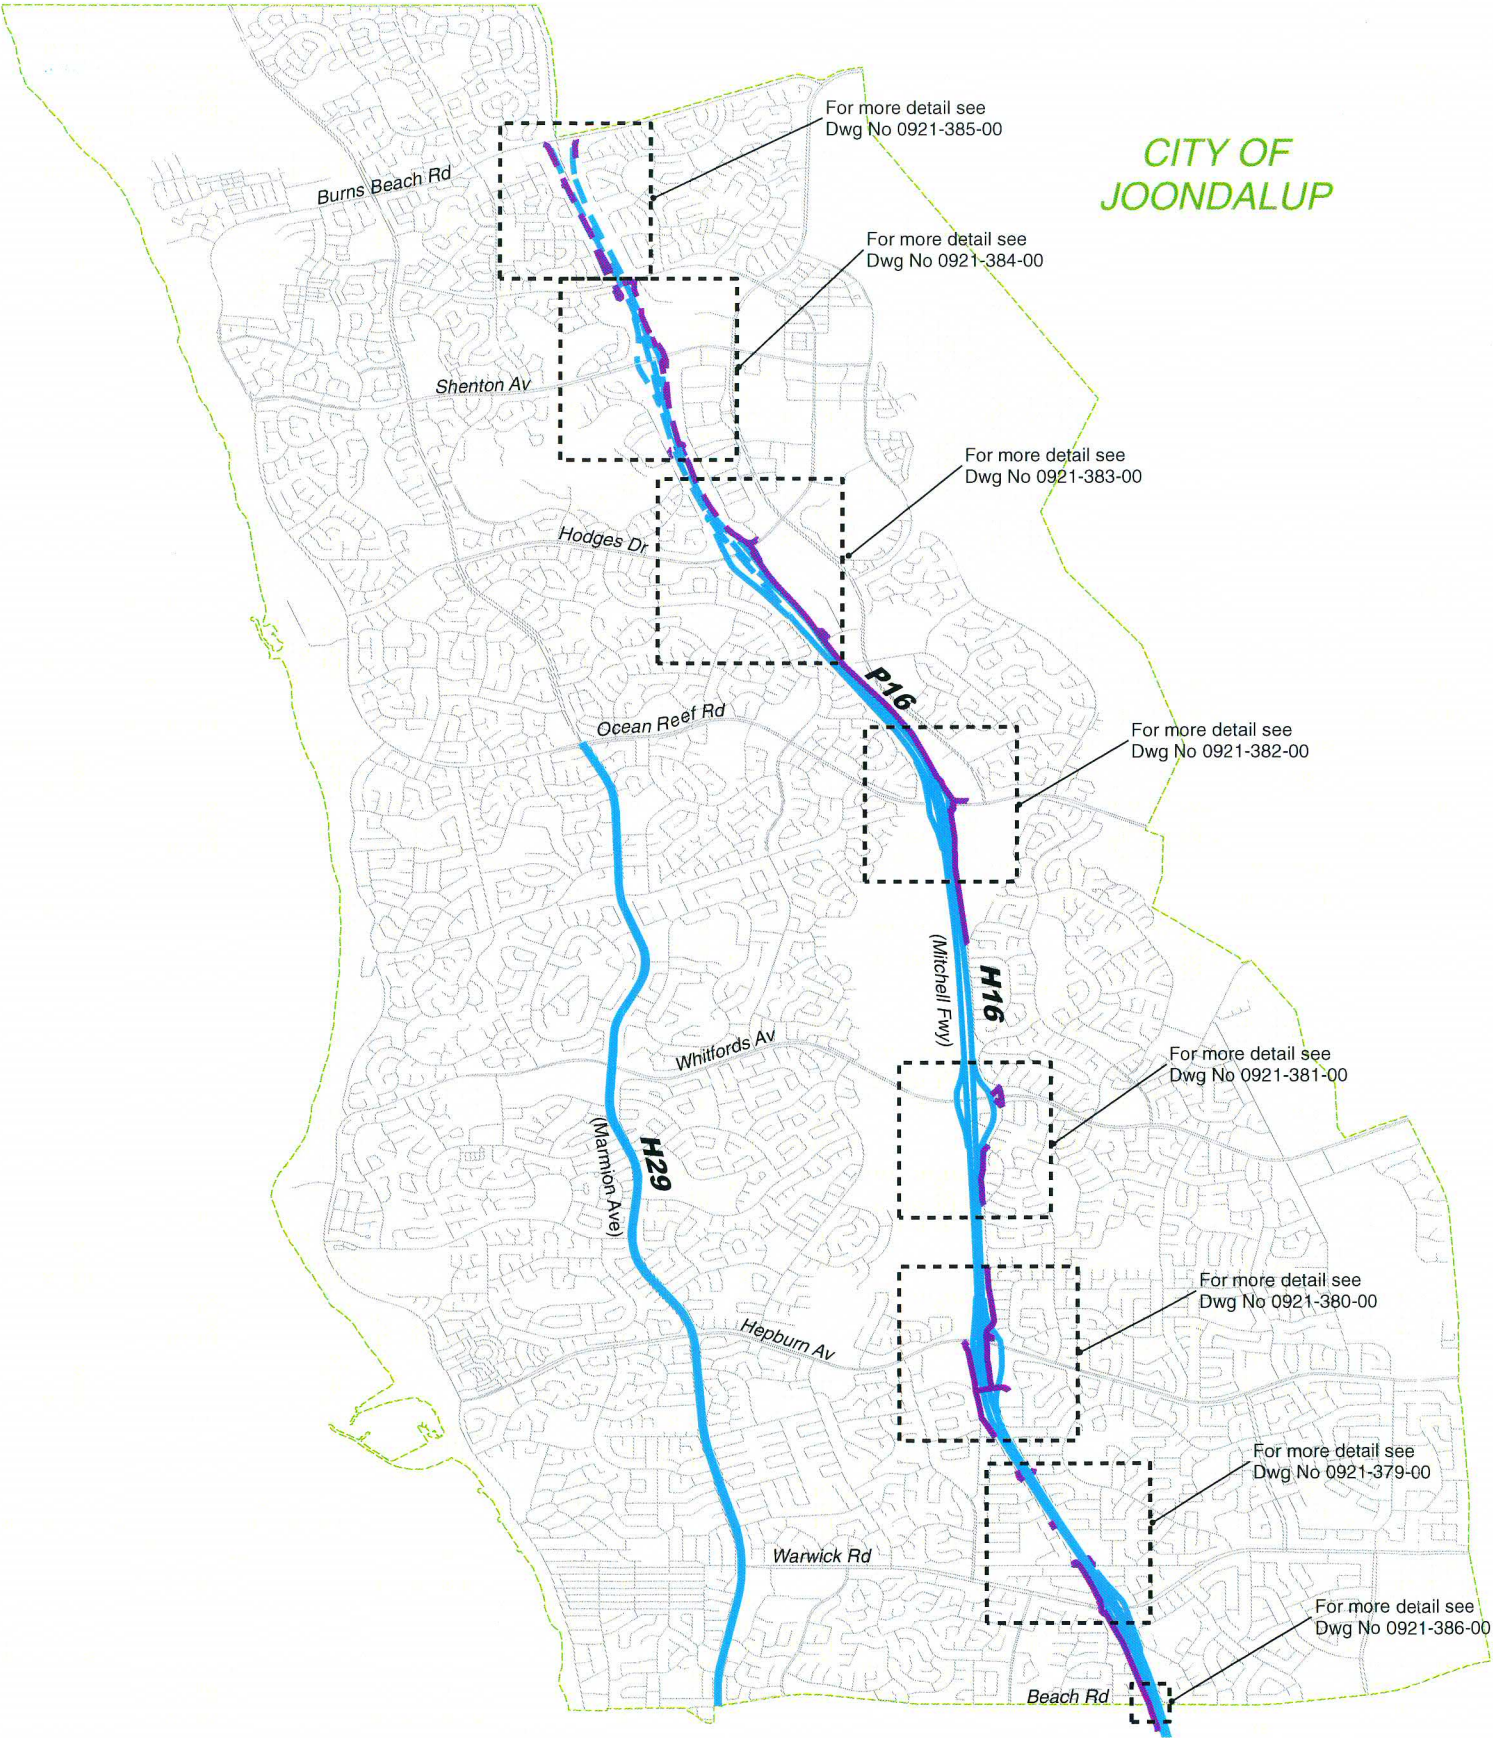


NOTES:

Roads and/or paths are represented by centrelines which are a notional reference line that generates and approximates the centre of the pavement extent.

Ramp intersections are shown schematically. The point at which the lines meet represents the end of the median which separates the converging or diverging carriageways.



METROPOLITAN  
REGION

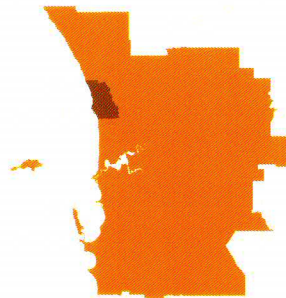

CITY OF  
JOONDALUP

BASE MAP  
LEGEND

- Town Site Area And Boundary
- Local Government Area And Boundary
- Cadastre
- Local Road


NOTE: FOR DETAIL OF TOWNSITES - REFER TO TOWNSITE DRAWINGS

DATE OF ORIGINAL ISSUE: ..... Add Date For Original Drawing Number

DRAWING AMENDMENT DATE: ..... Add Date For Amendments

RECOMMENDED *5/5/09*

APPROVED *Ben Pickin* *11/5/09*

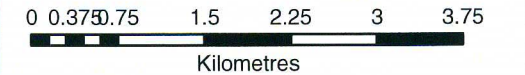

Planning and Technical Services Directorate

**PROCLAMATION PLAN**

Declared Roads

**JOONDALUP CITY**

CITY of JOONDALUP - LG No. 131

SHEET 1 of 1

| MAIN ROADS WESTERN AUSTRALIA |         |             |
|------------------------------|---------|-------------|
| DWG TYPE                     | FILE No | DWG NUMBER  |
| 20:00                        | 08/6841 | 0921-378-01 |