

AMENDMENTS

1. Proclaim H016, Mitchell Fwy and Ramp H264

PROCLAMATION  
LEGEND

EXISTING PROCLAIMED ROUTE

**H006** Highway  
(^ Road Name)

**M042** Main Road  
(^ Road Name)

SECTION TO BE DEPROCLAIMED

~~**H002**~~ ~~**M012**~~

SECTION TO BE PROCLAIMED

**H006** Highway

**M042** Main Road

^ Landgate approved local usage name.

PATHWAY RESPONSIBILITY

**P018** Main Roads Controlled Path

**P018** Other Path

~~**P018**~~ MR Controlled Path Removed

Controlled paths (shared, pedestrian or bicycle) depicted on this drawing are those for which Main Roads Western Australia has responsibility.

Paths, shared, pedestrian or bicycle, the responsibility of other entities are not shown.

This is to certify that Council endorses the proposal shown on this plan.

Council Resolution:.....of

Council Meeting Held On:

**OR DELEGATED AUTHORITY**  
in accordance with Section 5.41(d) of  
the Local Government Act 1995.

Chief Executive Officer

Date:.....

Gazette:.....

Page No:.....

DATE OF ORIGINAL ISSUE:

DRAWING AMENDMENT DATE: 21 Sept 19


THIS DRAWING SUPERSEDES: 0921-378-01

NOTES:

Roads and/or paths are represented by centrelines which are a notional reference line that generates and approximates the centre of the pavement extent.

Ramp intersections are shown schematically. The point at which the lines meet represents the end of the median which separates the converging or diverging carriageways.

CITY OF  
JOONDALUP

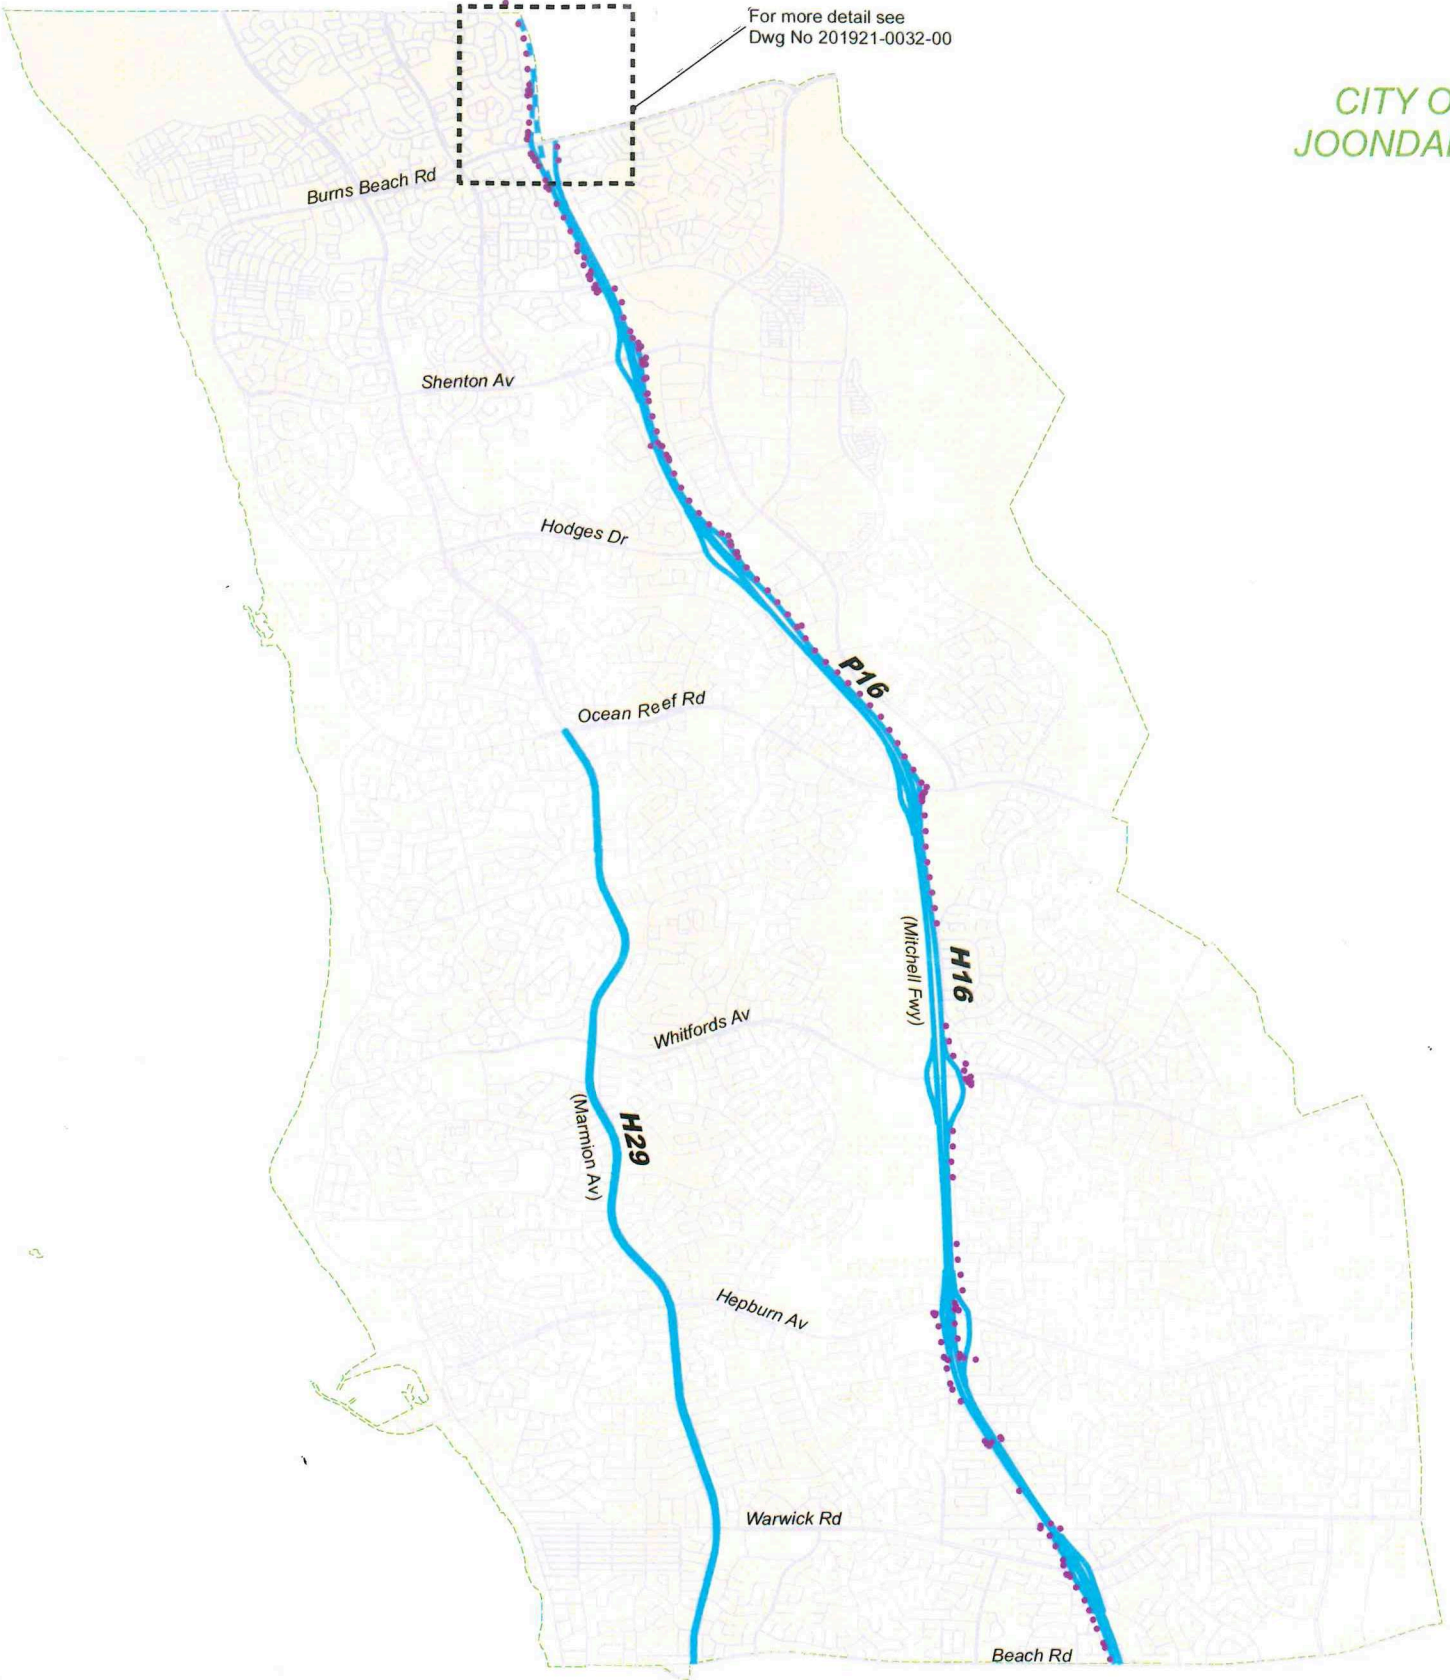

METROPOLITAN  
REGION

CITY OF  
JOONDALUP


BASE MAP  
LEGEND

- Town Site Area And Boundary
- Local Government Area And Boundary
- Cadastre
- Local Road

NOTE: FOR DETAIL OF TOWNSITES - REFER TO TOWNSITE DRAWINGS

RECOMMENDED  
Signature: *P. P.*  
Position: N.P.D.M.  
Date: 2/3/2021

APPROVED  
Signature: *[Signature]*  
Position: A/EDPTS  
Date: 10/02/21

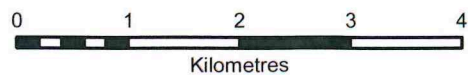

Planning and Technical Services Directorate

**PROCLAMATION PLAN**  
Declared Roads  
CITY of JOONDALUP  
CITY OF JOONDALUP - LG No. 131  
SHEET 1 of 1

**MAIN ROADS WESTERN AUSTRALIA**  
DWG TYPE: 20:00  
FILE No: 13/5044  
DWG NUMBER: 200921-378-02



## PROCLAMATION LEGEND

**H006** Highway  
(^ Road Name)

**M042** Main Road  
(^ Road Name)

**H002** **M012**

**H006** Highway  
**M042** Main Road

<sup>a</sup> Landgate approved local usage name.

**P018** Main Roads Controlled Path  
Other Path  
**P018** MR Controlled Path Removed  
Controlled paths (shared, pedestrian or bicycle) depicted on this drawing are those for which Main Roads Western Australia has responsibility.

Paths, shared, pedestrian or bicycle,  
the responsibility of other entities are not shown.

This is to certify that Council endorses  
the proposal shown on this plan.

Council Resolution:.....of

Council Meeting Held On:

**OR DELEGATED AUTHORITY**  
in accordance with Section 5.41(d) of  
the Local Government Act 1995.

Chief Executive Officer

Date: .....

Gazette:.....

Page No:.....

DATE OF ORIGINAL ISSUE: 21 Sept 19

DRAWING AMENDMENT DATE:

THIS DRAWING SUPERSEDES

NOTE: FOR DETAIL OF TOWNSITES - REFER TO TOWNSITE DRAWINGS

## PROCLAMATION PLAN

Proclaim H016 - Mitchell Fwy,  
Ramp H264 and Indicate P016

CITY of JOONDALUP - LG No. 131

SHEET 1 of 1

## MAIN ROADS WESTERN AUSTRALIA

DWG TYPE

FILE NO.

DWG NUMBER

201921-0032-00

20:00

13/5044